



STUDIO LOCI, LLC
RESIDENTIAL . COMMERCIAL . DESIGN

P - 713.303.8630
F - 713.583.9131

THE PLAN AND THE DESIGNS CONTAINED HEREIN ARE THE PROPERTY OF Studio LocI, LLC. THIS DRAWING SET AND ALL OF ITS CONTENTS ARE SUBJECT TO COPYRIGHT AND MAY NOT BE REPRODUCED, TRANSFERRED OR REPRODUCED ALL OR IN PART, WITHOUT PRIOR WRITTEN CONSENT FROM THE OWNER OR HIS ASSIGNS.

COPYRIGHT 2014 © Studio LocI, LLC


NO. DATE ISSUE/REVISION

NO.	DATE	ISSUE/REVISION



6 LEFT ELEVATION

SCALE: 1/4" = 1'-0"

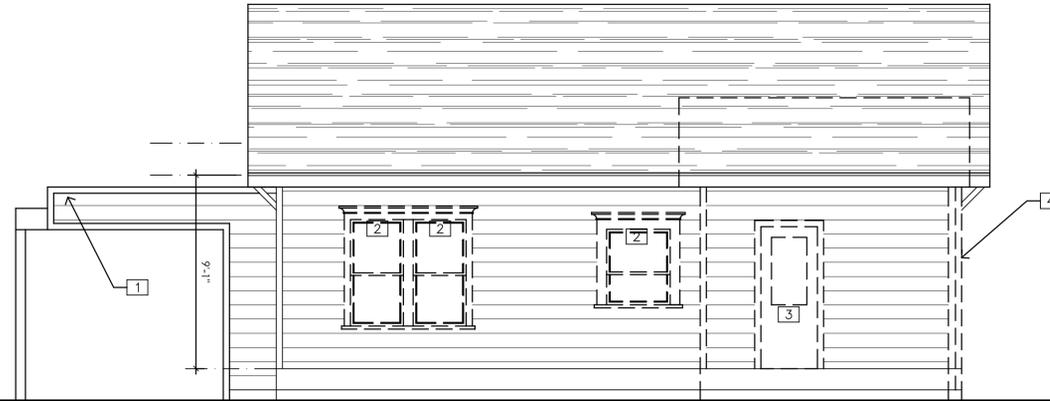


5 REAR ELEVATION

SCALE: 1/4" = 1'-0"




4 RIGHT ELEVATION

SCALE: 1/4" = 1'-0"

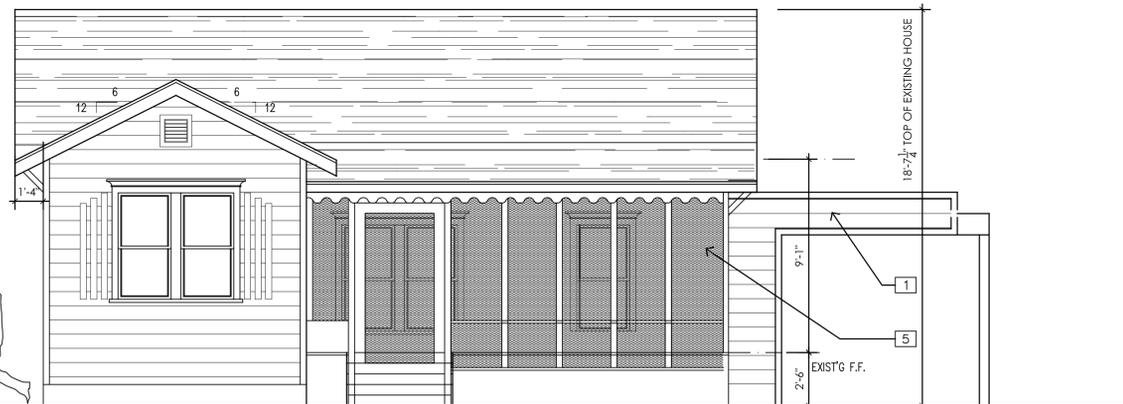

3 FRONT ELEVATION

SCALE: 1/4" = 1'-0"

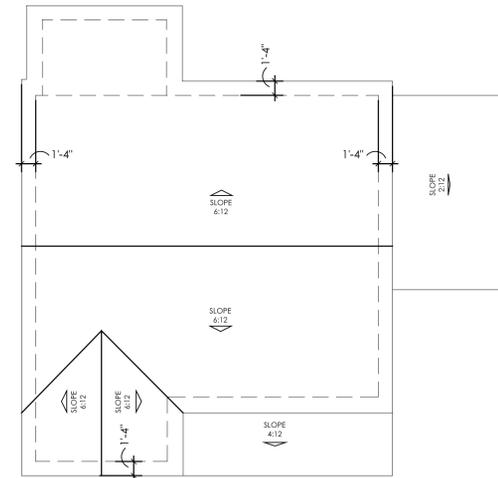


2 EXISTING ROOF PLAN

SCALE: 1/8" = 1'-0"

DEMO NOTES:

- 1 CARPORT TO REMAIN - REINFORCE AS NECESSARY.
- 2 REMOVE WINDOW AND STORE TO REPAIR OTHERS TO REMAIN.
- 3 REMOVE DOOR.
- 4 REMOVE EXTERIOR WALL, SIDING & ROOFING.
- 5 SCREEN PORCH TO REMAIN - REPAIR AS NECESSARY.
- 6 REMOVE ALL INTERIOR FIXTURES, FINISHES & MECHANICAL

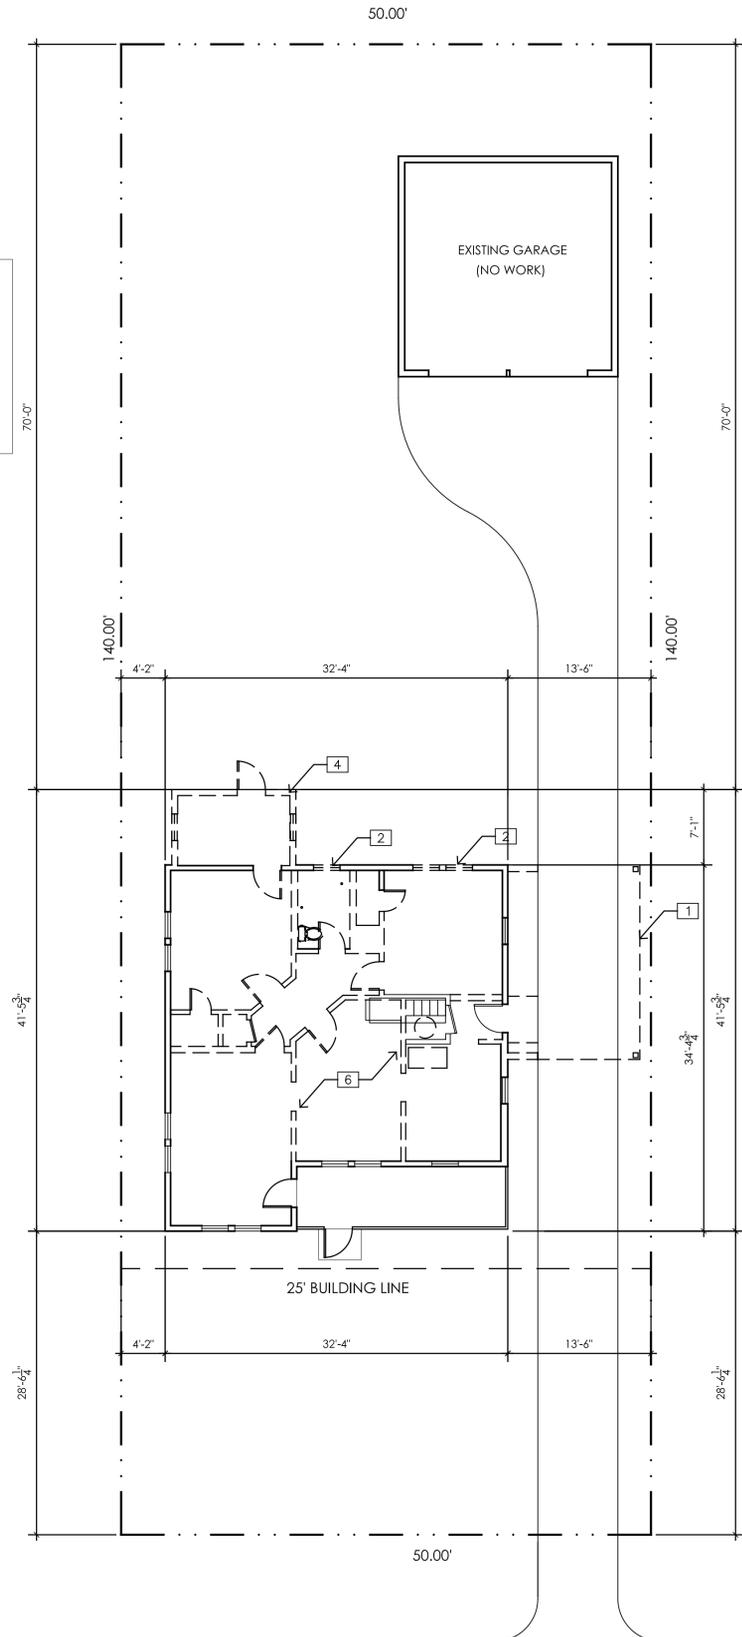

1 EXISTING SITE/FLOOR PLAN

SCALE: 1/8" = 1'-0"

ARLINGTON STREET



white residence

Project Address :
825 Arlington St
Houston, TX 77007


DATE : 08 / 23 / 14

TITLE :


AS-BUILTS

SHEET # :


A0

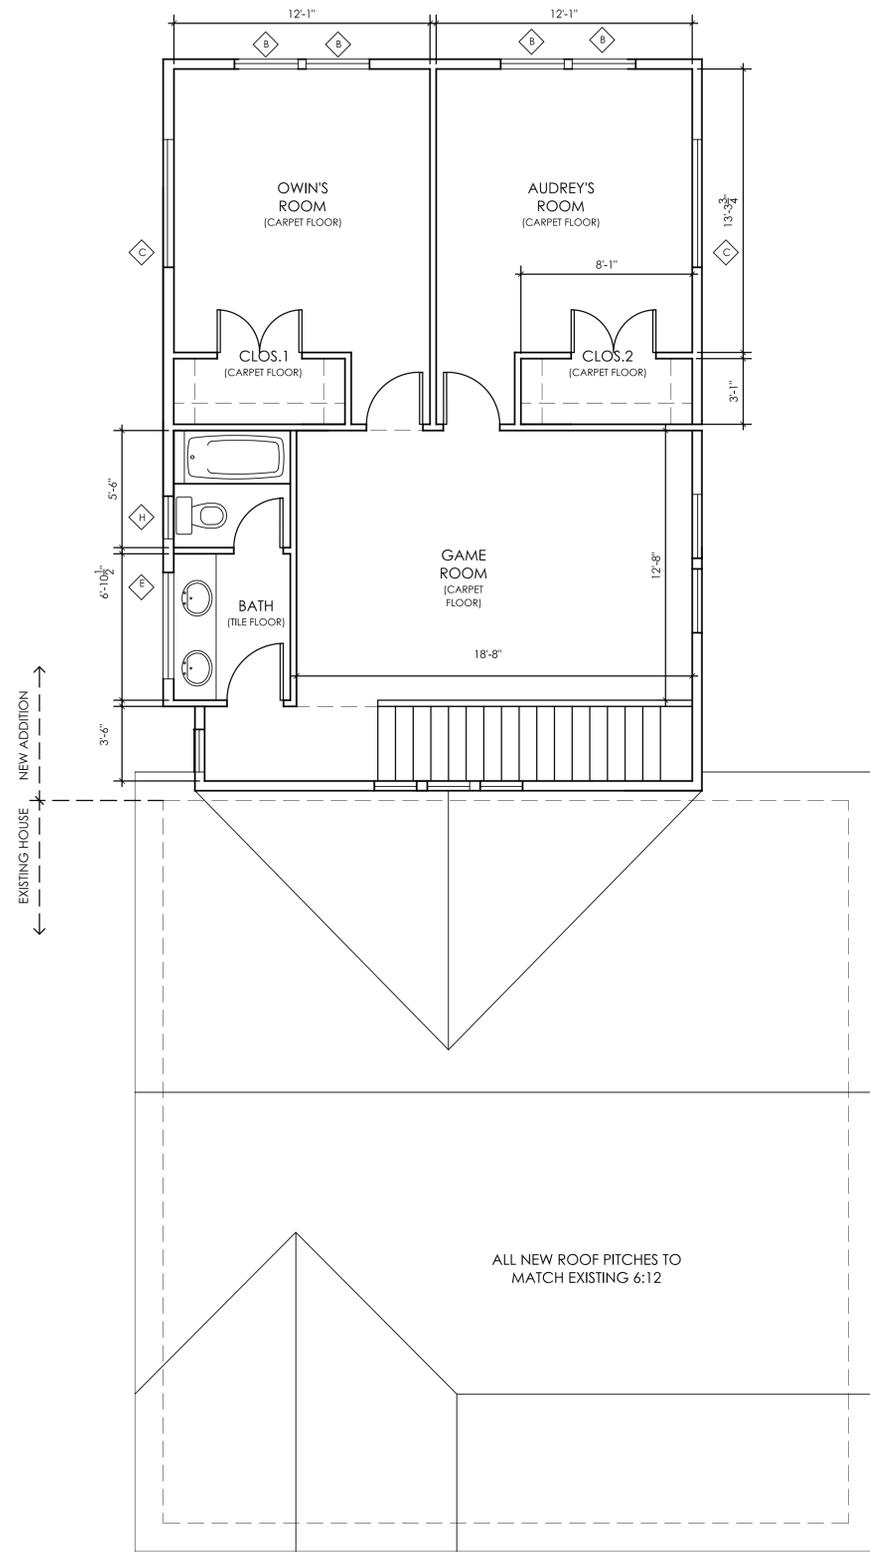

2 PROPOSED SECOND FLOOR - PLAN
SCALE: 1/4" = 1'-0"

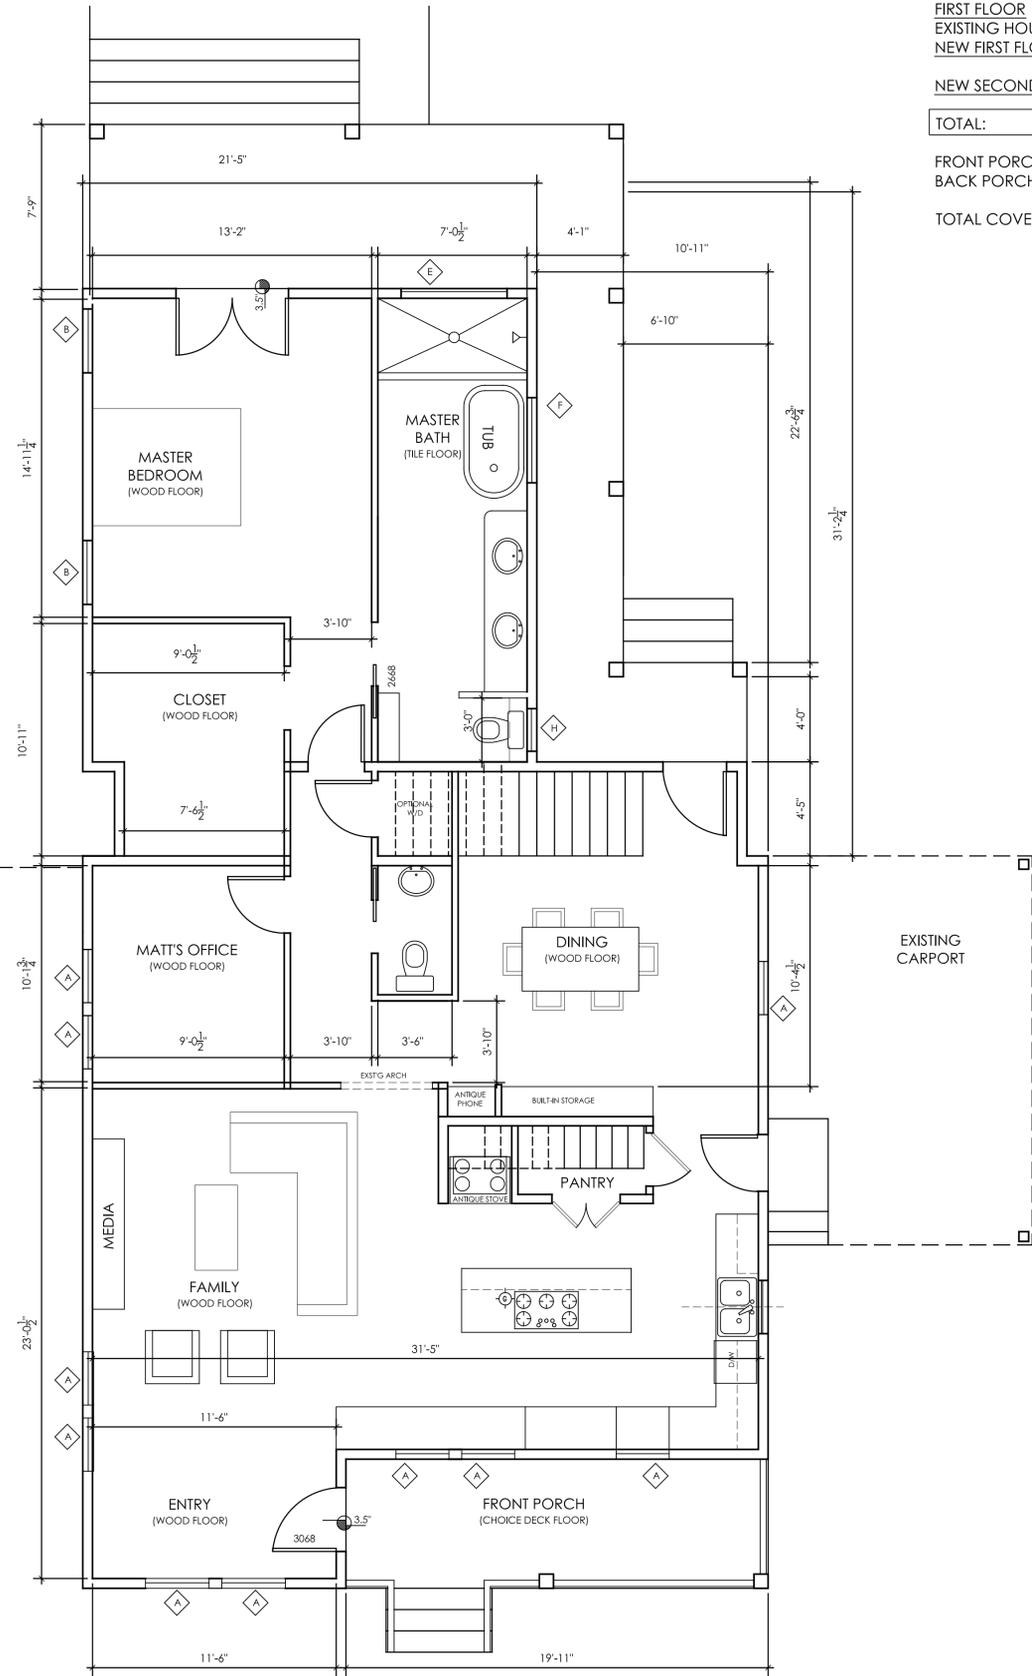

1 PROPOSED FIRST FLOOR - PLAN
SCALE: 1/4" = 1'-0"

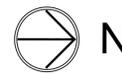

AREA:

FIRST FLOOR	
EXISTING HOUSE :	991 SF
NEW FIRST FLOOR:	465 SF
NEW SECOND FLOOR :	700 SF
TOTAL:	2,156 SF
FRONT PORCH:	121 SF
BACK PORCH :	300 SF
TOTAL COVERED:	2,577 SF

STUDIO LOCI, LLC
RESIDENTIAL · COMMERCIAL · DESIGN
P - 713.303.8630
E - 713.583.9131

THIS PLAN AND THE DESIGNS CONTAINED HEREIN ARE THE PROPERTY OF Studio LocI, LLC. THIS DRAWING SET AND ALL OF ITS CONTENTS ARE SUBJECT TO COPYRIGHT AND MAY NOT BE REPRODUCED, TRANSFERRED OR REPRODUCED ALL OR IN PART, WITHOUT PRIOR WRITTEN CONSENT FROM THE OWNER OR HIS AGENTS.
COPYRIGHT 2014 © Studio LocI, LLC

NO.	DATE	ISSUE/REVISION

white residence

Project Address :
825 Arlington St
Houston, TX 77007

DATE : 08 / 23 / 14

TITLE :

FLOOR PLANS

SHEET #:

A2



STUDIO LOCI, LLC
RESIDENTIAL . COMMERCIAL . DESIGN

P - 713.303.8630
F - 713.583.9131

THIS PLAN AND THE DESIGNS CONTAINED HEREIN ARE THE PROPERTY OF Studio LocI, LLC. THIS DRAWING SET AND ALL OF ITS CONTENTS ARE SUBJECT TO COPYRIGHT AND MAY NOT BE REPRODUCED, TRANSFERRED OR REPRODUCED ALL OR IN PART, WITHOUT PRIOR WRITTEN CONSENT FROM THE OWNER OR HIS ASSIGNS.

COPYRIGHT 2014 © Studio LocI, LLC

KEY NOTES:

- ① NEW LOW "E" FIXED WINDOW TO MATCH EXISTING STYLE.
- ② NEW WOOD SIDING TO MATCH EXISTING.
- ③ NEW CORBEL TO MATCH EXISTING.
- ④ NEW 30 YEAR ROOF ON 1/2" TECH SHIELD WITH 30# FELT.
- ⑤ EXISTING WOOD WINDOW TO REMAIN. REPAIR AS NECESSARY.
- ⑥ NEW COMPOSITE WOOD DECKING. OWNER TO SELECT COLOR.
- ⑦ EXISTING PORCH TO REMAIN.
- ⑧ EXISTING FASCIA TO REMAIN. REPAIR AS NECESSARY



1 PROPOSED FRONT ELEVATION

SCALE: 1/4" = 1'-0"



2 PROPOSED RIGHT ELEVATION

SCALE: 1/4" = 1'-0"

← EXISTING HOUSE NEW ADDITION →

NO.	DATE	ISSUE/REVISION

white residence

Project Address :
825 Arlington St
Houston, TX 77007

DATE : 08 / 23 / 14

TITLE :

ELEVATIONS

SHEET # :

A3



STUDIO LOCI, LLC
RESIDENTIAL . COMMERCIAL . DESIGN

P - 713.303.8630
F - 713.583.9131


THE PLAN AND THE DESIGNS CONTAINED HEREIN ARE THE PROPERTY OF Studio LocI, LLC. THIS DRAWING SET AND ALL OF ITS CONTENTS ARE SUBJECT TO COPYRIGHT AND MAY NOT BE REPRODUCED, TRANSFERRED OR REPRODUCED ALL OR IN PART, WITHOUT PRIOR WRITTEN CONSENT FROM THE OWNER OR HIS ASSIGNS.

COPYRIGHT 2014 © Studio LocI, LLC

NO. DATE ISSUE/REVISION



3 PROPOSED REAR ELEVATION
SCALE: 1/4" = 1'-0"

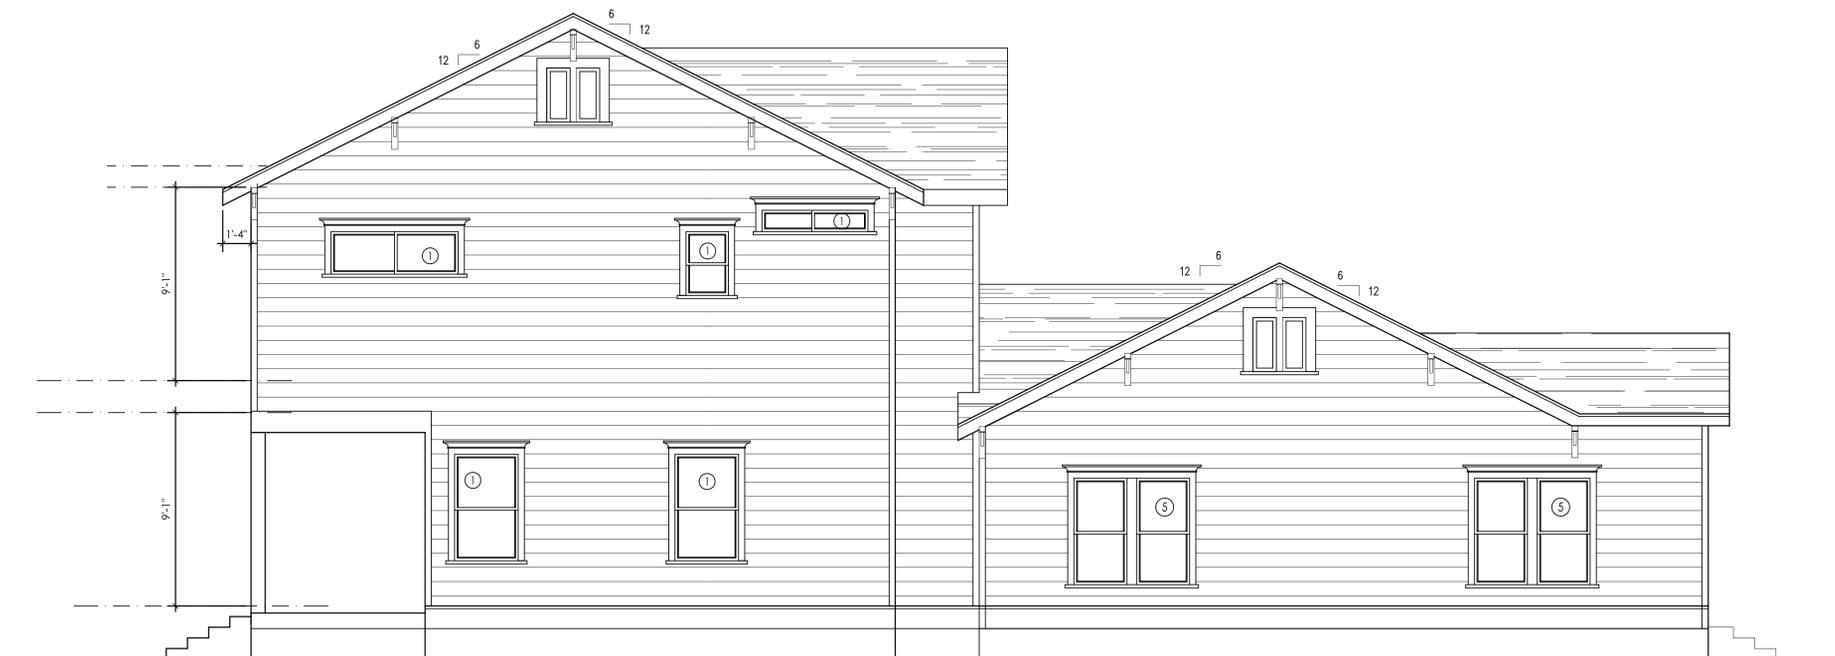

4 PROPOSED LEFT ELEVATION
SCALE: 1/4" = 1'-0"

NEW ADDITION | EXISTING HOUSE
←-----|-----→

white residence

Project Address :
825 Arlington St
Houston, TX 77007

DATE : 08 / 23 / 14

TITLE :

ELEVATIONS

SHEET # :

A4

CERTIFICATE OF APPROPRIATENESS APPLICATION FORM



PLANNING &
DEVELOPMENT
DEPARTMENT

PROPERTY

Address 825 Arlington Street Houston, TX 77007

Historic District / Landmark Houston Heights South

HCAD # 0202450000007

Subdivision Houston Heights

Lot lot 7 Block 29

DESIGNATION TYPE

- Landmark
 Protected Landmark
 Archaeological Site
 Contributing
 Noncontributing
 Vacant

PROPOSED ACTION

- Alteration or Addition
 Restoration
 New Construction
 Relocation
 Demolition
 Excavation

DOCUMENTS

- Application checklist for each proposed action and all applicable documentation listed within are attached

OWNER

Name Lauren White

Company

Mailing Address 1348 Chippendale RD
Houston, TX 77018

Phone 281/235/8394

Email

Signature

Date March 4, 2015

APPLICANT (if other than owner)

Name Tim O'Leary

Company Studio Loci, LLC

Mailing Address 21806 Stargrass
Spring, TX 77388

Phone 713/303/8630

Email

Signature

Date March 4, 2015

ACKNOWLEDGEMENT OF RESPONSIBILITY

Requirements: A complete application includes all applicable information requested on checklists to provide a complete and accurate description of existing and proposed conditions. Preliminary review meeting or site visit with staff may be necessary to process the application. Owner contact information and signature is required. Late or incomplete applications will not be considered.


Deed Restrictions: You have verified that the work does not violate applicable deed restrictions.

Public Records: If attached materials are protected by copyright law, you grant the City of Houston, its officers, agencies, departments, and employees, non-exclusive rights to reproduce, distribute and publish copyrighted materials before the Houston Archaeological and Historical Commission, the Planning Commission, City Council, and other City of Houston commissions, agencies, and departments, on a City of Houston website, or other public forum for the purposes of application for a Certificate of Appropriateness or building permit, and other educational and not for profit purposes. You hereby represent that you possess the requisite permission or rights being conveyed here to the City.

Compliance: If granted, you agree to comply with all conditions of the COA. Revisions to approved work require staff review and may require a new application and HAHC approval. Failure to comply with the COA may result in project delays, fines or other penalties.

Planner: _____ Application received: ___/___/___ Application complete: ___/___/___


1-WIDE UNIT

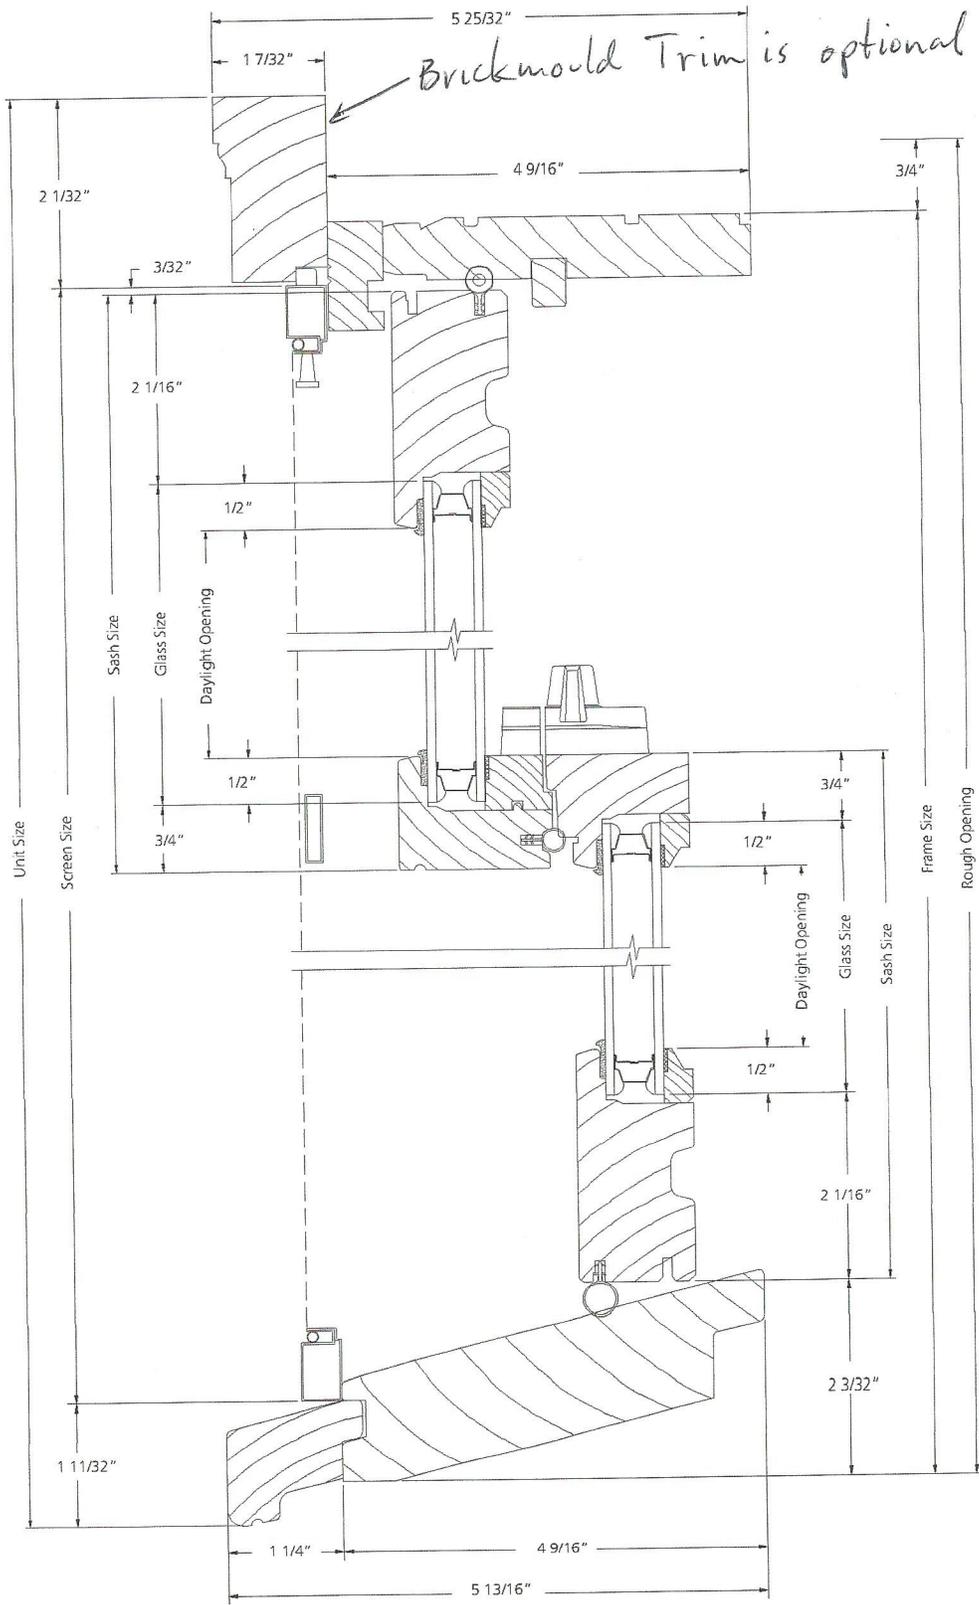

VERTICAL SECTION

SCALE: 6" = 1'

1-WIDE UNIT

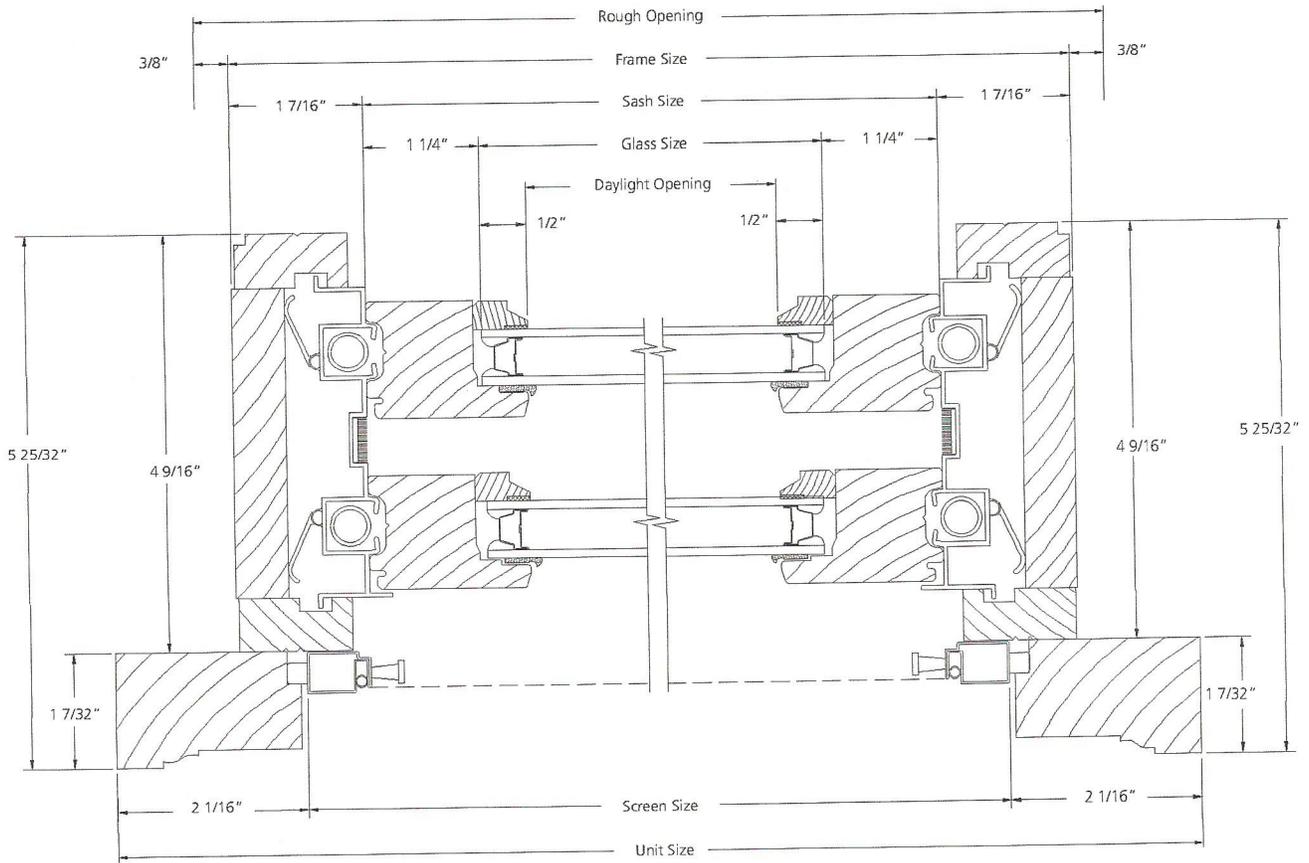

HORIZONTAL SECTION

SCALE: 6" = 1'